

Work Order ID 147748

June 10, 2016 2:41:48 PM

U/R

147748

Beef Only

Page 1

Item ID: D3594-043

Accept

N900040100

Setup Start ***NS1***

Revision ID: URF 16-531

Stop ***NS2***

Item Name: Floor Doubler Assembly, LH

Start Date: 6/10/2016 Start Qty: 5.00

5

Cust Item ID:

Required Date: 6/15/2016 Req'd Qty: 5.00

5

Customer:

Reference:

Approvals:

Process Plan: SA

Date: 6/10/16

Tooling:

Date:

Run Start ***NR1***

QC:

Date:

SPC (Y/N):

Date:

Stop ***NR2***

Sequence ID/
Work Center ID

Operation
Description

Set Up/
Run Hours

Tool ID

Tool # Plan
Code

Accept
Qty

Reject
Qty

Reject
Number

Insp.
Stamp

Draw Nbr

Revision Nbr

D3594

Rev B U/R

OK d/16/6/13

100

0.00

100

FLOW WATER JET

Waterjet

Memo

0.08

FLOW CNC Waterjet

1-Cut as per Dwg D3594

Dwg Rev: B

Prog Rev: B

2-Deburr if necessary

110

QC2- Inspect parts off machine FAI/FAIB

0.00

110

QC

Memo

0.01

Quality Control

DQA:

Date: 16/07/08

QA Closed: ~~RAA~~

Date: 16/07/04

WORK ORDER NON-CONFORMANCE / UPDATE

Work Order update only ☐

Work Order: 147748		DISPOSITION		AGAINST DEPARTMENT/PROCESS					
Part No. P2594-043		Rework ☒		Skid-tube ☐	Cross tube ☐	Water Jet ☐	Engineering ☒		
NCR No. 16-5889		Scrap ☐		Machining ☐	Small Fab ☐	Prod. Eng. Coord. ☐	Quality ☐		
		Use-as-is ☐		Thermoforming ☐	Finishing ☐	Rec/Store/Packaging ☐	Other ☐		
		Suspected Unapproved ☐		Large Fab ☐	Composite ☐	Supplier ☐			
Date: 16/6/13		Step #: 100		QTY Effective: 5			MRB (QSI042) Approval		
							DAS 12 9-89 16/6/13		
Description Work Order Deviation				Disposition					
Cut with dims modified per attached mark-up.				Acceptable.				Completed By	
								16/07/04	
								Lead hand / Supervisor Approval Verification	
								DAS 9 9-89 16-07-04	
								QC / QA Coordinator Approval	
								DAS 9 9-89 16-07-04	
Root Cause				FAULT CATEGORY					
Environment ☐	No Re-verification ☐	Pressure/Forced ☐	Temperature/Cure ☐	Power Loss/Surge ☐	Positioned Wrong ☐				
Design ☒	Operator ☐	Bending ☐	Set-up ☐	Folio/Program ☐	Outside Dimensions ☐				
Doc/Data ☐	Offset/Setup ☐	Centre Not Concentric ☐	BOM/Route ☐	Grain ☐	Over/Under tolerance ☐				
Equip/Tooling ☐	Supplier ☐	Cracks ☐	Broken/Damage/Defect ☐	Weld ☐	Part Incorrect ☐				
Handling/Pre ☐	Training ☐	Crimp/Kink/Ripple/Wave ☐	Inspection Incomplete/Unqualified ☐	Wrong Stock Pulled ☐	Part Lost/Missing ☐				
Material ☐	Use for Testing ☐	Cuffs ☐	Contamination ☐	Out of Sequence ☐	Part Moved ☐				
Internal Transport ☐	Poor Information ☐	Crushing ☐	Countersink ☐	Off-set ☐	✓ Drawing ☒				
Tribal Knowledge ☐	Rushing ☐	Heat Treat ☐	Cut Too Short ☐	Mislabeled ☐	Finish ☐				
LOA ☒	Product Improvement ☐	Wave/Twist in Tube ☐	Instructions Incomplete/Unclear ☐	Fit/Function ☐	Misread ☐				
Substation ☐	Process Improvement ☐	Marks/Chatter ☐	Drill Holes ☐	Misaligned/off center ☐	Turning Sequence ☐				
Past Expiry Date ☐	Manufacturing Process ☐								
Misidentified ☐	Past Due ☐	OTHER :							

DQA: _____ Date: _____



WORK ORDER NON-CONFORMANCE / UPDATE

QA Closed: _____ Date: _____

Work Order update only ☐

Work Order: _____ Part No. _____ NCR No. _____		DISPOSITION Rework ☐ Scrap ☐ Use-as-is ☐ Suspected Unapproved ☐		AGAINST DEPARTMENT/PROCESS Skid-tube ☐ Machining ☐ Thermoforming ☐ Large Fab ☐ Cross tube ☐ Small Fab ☐ Finishing ☐ Composite ☐ Water Jet ☐ Prod. Eng. Coord. ☐ Rec/Store/Packaging ☐ Supplier ☐ Engineering ☐ Quality ☐ Other ☐					
Date :		Step #:		QTY Effective :			MRB (QSI042) Approval 		
Description Work Order Deviation				Disposition					
							Completed By		
							Lead hand / Supervisor Approval Verification		
							QC / QA Coordinator Approval		
Root Cause Environment ☐ Design ☐ Doc/Data ☐ Equip/Tooling ☐ Handling/Pre ☐ Material ☐ Internal Transport ☐ Tribal Knowledge ☐ LOA ☐ Substation ☐ Past Expiry Date ☐ Misidentified ☐ No Re-verification ☐ Operator ☐ Offset/Setup ☐ Supplier ☐ Training ☐ Use for Testing ☐ Poor Information ☐ Rushing ☐ Product Improvement ☐ Process Improvement ☐ Manufacturing Process ☐ Past Due ☐		FAULT CATEGORY Pressure/Forced ☐ Bending ☐ Centre Not Concentric ☐ Cracks ☐ Crimp/Kink/Ripple/Wave ☐ Cuffs ☐ Crushing ☐ Heat Treat ☐ Wave/Twist in Tube ☐ Marks/Chatter ☐ Temperature/Cure ☐ Set-up ☐ BOM/Route ☐ Broken/Damage/Defect ☐ Inspection Incomplete/Unqualified ☐ Contamination ☐ Countersink ☐ Cut Too Short ☐ Instructions Incomplete/Unclear ☐ Drill Holes ☐ Power Loss/Surge ☐ Folio/Program ☐ Grain ☐ Weld ☐ Wrong Stock Pulled ☐ Out of Sequence ☐ Off-set ☐ Misabeled ☐ Fit/Function ☐ Misaligned/off center ☐ Positioned Wrong ☐ Outside Dimensions ☐ Over/Under tolerance ☐ Part Incorrect ☐ Part Lost/Missing ☐ Part Moved ☐ Drawing ☐ Finish ☐ Misread ☐ Turning Sequence ☐							
OTHER : ☐									

Work Order ID 147748

147748

Page 3

June 10, 2016 2:41:48 PM

Item ID: D3594-043 Accept ***N900040100*** Setup Start ***NS1***
Revision ID: URF 16-531 Stop ***NS2***
Item Name: Floor Doubler Assembly, LH
Start Date: 6/10/2016 Start Qty: 5.00 ***5*** Cust Item ID:
Required Date: 6/15/2016 Req'd Qty: 5.00 ***5*** Customer:
Reference:

Approvals: Process Plan: _____ Date: _____ Tooling: _____ Date: _____ Run Start ***NR1***
QC: _____ Date: _____ SPC (Y/N): _____ Date: _____ Stop ***NR2***

Sequence ID/ Work Center ID	Operation Description	Set Up/ Run Hours	Tool ID	Tool #	Plan Code	Accept Qty	Reject Qty	Reject Number	Insp. Stamp
150	Chemical Conversion Coat per QSI005 4.1	0.00							
150									
HandFinish	Memo	0.04				5			
Hand Finishing									16-06-18
160	QC7-Inspect Chemical Conversion Coat	0.00							
160									
QC	Memo	0.01				5			
Quality Control									
170	Small Fab	0.00							
170									
Small Fab	Memo	0.03				5			
Small Fab	Install Nut Plates As per Dwg D3594								16/06/20

DAS
36
9-89

DQA: _____ Date: _____



WORK ORDER NON-CONFORMANCE / UPDATE

QA Closed: _____ Date: _____

Work Order update only ☐

Work Order: _____ Part No. _____ NCR No. _____		DISPOSITION Rework ☐ Scrap ☐ Use-as-is ☐ Suspected Unapproved ☐		AGAINST DEPARTMENT/PROCESS Skid-tube ☐ Machining ☐ Thermoforming ☐ Large Fab ☐ Cross tube ☐ Small Fab ☐ Finishing ☐ Composite ☐ Water Jet ☐ Prod. Eng. Coord. ☐ Rec/Store/Packaging ☐ Supplier ☐ Engineering ☐ Quality ☐ Other ☐					
Date :		Step #:		QTY Effective :			MRB (QSI042) Approval		
Description Work Order Deviation				Disposition				Completed By	
								Lead hand / Supervisor Approval Verification	
								QC / QA Coordinator Approval	
Root Cause				FAULT CATEGORY					
Environment ☐	No Re-verification ☐	Pressure/Forced ☐	Temperature/Cure ☐	Power Loss/Surge ☐	Positioned Wrong ☐				
Design ☐	Operator ☐	Bending ☐	Set-up ☐	Folio/Program ☐	Outside Dimensions ☐				
Doc/Data ☐	Offset/Setup ☐	Centre Not Concentric ☐	BOM/Route ☐	Grain ☐	Over/Under tolerance ☐				
Equip/Tooling ☐	Supplier ☐	Cracks ☐	Broken/Damage/Defect ☐	Weld ☐	Part Incorrect ☐				
Handling/Pre ☐	Training ☐	Crimp/Kink/Ripple/Wave ☐	Inspection Incomplete/Unqualified ☐	Wrong Stock Pulled ☐	Part Lost/Missing ☐				
Material ☐	Use for Testing ☐	Cuffs ☐	Contamination ☐	Out of Sequence ☐	Part Moved ☐				
Internal Transport ☐	Poor Information ☐	Crushing ☐	Countersink ☐	Off-set ☐	Drawing ☐				
Tribal Knowledge ☐	Rushing ☐	Heat Treat ☐	Cut Too Short ☐	Mislabeled ☐	Finish ☐				
LOA ☐	Product Improvement ☐	Wave/Twist in Tube ☐	Instructions Incomplete/Unclear ☐	Fit/Function ☐	Misread ☐				
Substation ☐	Process Improvement ☐	Marks/Chatter ☐	Drill Holes ☐	Misaligned/off center ☐	Turning Sequence ☐				
Past Expiry Date ☐	Manufacturing Process ☐								
Misidentified ☐	Past Due ☐	OTHER : _____							

Work Order ID 147748

147748

Page 4

June 10, 2016 2:41:48 PM

Item ID: D3594-043 Accept ***N900040100*** Setup Start ***NS1***
 Revision ID: URF 16-531 Stop ***NS2***
 Item Name: Floor Doubler Assembly, LH
 Start Date: 6/10/2016 Start Qty: 5.00 ***5*** Cust Item ID:
 Required Date: 6/15/2016 Req'd Qty: 5.00 ***5*** Customer:
 Reference:

Approvals: Process Plan: _____ Date: _____ Tooling: _____ Date: _____ Run Start ***NR1***
 QC: _____ Date: _____ SPC (Y/N): _____ Date: _____ Stop ***NR2***

Sequence ID/ Work Center ID	Operation Description	Set Up/ Run Hours	Tool ID	Tool #	Plan Code	Accept Qty	Reject Qty	Reject Number	Insp. Stamp
180	QC5- Inspect part completeness to step on W/O	0.00							
180									
QC	Memo	0.02							DAS 9 9-88
Quality Control									
190	Identify as per dwg & Stock Location: _____	0.00							
190	Pat Duval's Office.								
Packaging	Memo	0.01							DAS 9 9-88
Packaging									
200	QC21- Final Inspection - Work Order Release	0.00							
200									
QC	Memo	0.08							
Quality Control									

MC5 JUN 21 2016

SA 6/21/16

DQA: _____ Date: _____



WORK ORDER NON-CONFORMANCE / UPDATE

QA Closed: _____ Date: _____

Work Order update only ☐

Work Order: _____ Part No. _____ NCR No. _____		DISPOSITION Rework ☐ Scrap ☐ Use-as-is ☐ Suspected Unapproved ☐		AGAINST DEPARTMENT/PROCESS Skid-tube ☐ Machining ☐ Thermoforming ☐ Large Fab ☐ Cross tube ☐ Small Fab ☐ Finishing ☐ Composite ☐ Water Jet ☐ Prod. Eng. Coord. ☐ Rec/Store/Packaging ☐ Supplier ☐ Engineering ☐ Quality ☐ Other ☐					
Date :		Step #:		QTY Effective :			MRB (QSI042) Approval Completed By _____ Lead hand / Supervisor Approval Verification _____ QC / QA Coordinator Approval _____		
Description Work Order Deviation				Disposition					
Root Cause Environment ☐ Design ☐ Doc/Data ☐ Equip/Tooling ☐ Handling/Pre ☐ Material ☐ Internal Transport ☐ Tribal Knowledge ☐ LOA ☐ Substation ☐ Past Expiry Date ☐ Misidentified ☐ No Re-verification ☐ Operator ☐ Offset/Setup ☐ Supplier ☐ Training ☐ Use for Testing ☐ Poor Information ☐ Rushing ☐ Product Improvement ☐ Process Improvement ☐ Manufacturing Process ☐ Past Due ☐		FAULT CATEGORY Pressure/Forced ☐ Bending ☐ Centre Not Concentric ☐ Cracks ☐ Crimp/Kink/Ripple/Wave ☐ Cuffs ☐ Crushing ☐ Heat Treat ☐ Wave/Twist in Tube ☐ Marks/Chatter ☐ Temperature/Cure ☐ Set-up ☐ BOM/Route ☐ Broken/Damage/Defect ☐ Inspection Incomplete/Unqualified ☐ Contamination ☐ Countersink ☐ Cut Too Short ☐ Instructions Incomplete/Unclear ☐ Drill Holes ☐ Power Loss/Surge ☐ Folio/Program ☐ Grain ☐ Weld ☐ Wrong Stock Pulled ☐ Out of Sequence ☐ Off-set ☐ Misabeled ☐ Fit/Function ☐ Misaligned/off center ☐ Positioned Wrong ☐ Outside Dimensions ☐ Over/Under tolerance ☐ Part Incorrect ☐ Part Lost/Missing ☐ Part Moved ☐ Drawing ☐ Finish ☐ Misread ☐ Turning Sequence ☐							
		OTHER : ☐							

Picklist Print

June 10, 2016 2:41:54 PM

Page 1

Work Order ID: 147748

147748

Parent Item: D3594-043

D3594-043

Parent Item Name: Floor Doubler Assembly, LH

Start Date: 6/10/2016

Required Date: 6/15/2016

Start Qty: 5.00

Required Qty: 5.00

Comments: IPP Rev :A New Issue 07-01-22 EC

Component Item ID/ Item Name	Replacement Item ID	Mfg/ Purch	Bin Item	Primary Location	Last Location	Route Seq ID	Unit of Measure	Qty on Hand	Qty per Kit	Total Qty	Qty Issued	Date Issued	Status
MS20426AD4-4		Purchased				100	Each	4,415.000	2	10			
MS20426AD4-4									**				
Rivet													

Location	Loc Qty	Loc Code
GA	1962	
125445	1962	
ST312	2453	
m132536	2453	

M6061T6S.080	Purchased	No				170	sf	302.6000	0.51	2.684211			
--------------	-----------	----	--	--	--	-----	----	----------	------	----------	--	--	--

M6061T6S 080

6061-T6 .080 Sheet

Location	Loc Qty	Loc Code
MAT020	302.6	
134217	26.4	
m132772	4.3	
m133587	7.7	
m133828	16.3	
m13455	17.9	
m134696	144	
m134830	86	

MS21069-5	Purchased	No				170	Each	74.0000	1	5			
-----------	-----------	----	--	--	--	-----	------	---------	---	---	--	--	--

MS21069-5

Anchor nuts

Location	Loc Qty	Loc Code
ST299	74	
m131920	74	

Under Review Notification

Raised By: M. BELLAVANCE

Date: 16.02.25

Product #: D412-698-023

Product Name: AUTOMATIC DOOR OPENER KIT


8A 147748
6/10/16

Part Number (D-Part and 9-Digit)	Drawing/Document & Current Affected Revision	"Y" or "N" Required for Each Part							Reserved ECN Log Number	Instructions Relevant to Each Part
		HOLD SHIPMENT	Red Tag/Quarantine Stock	Advise Customers	Stop Production	Re-Work Stock	IPP Under Review	Product Specifications Under Review		
D3594-043/-044/-3/-4	D3594 Rev. B	N	Y	N	Y	N	Y	N	16-531	See below.
D412-698-023	IIN-D412-698 Rev. E	N	Y	N	Y	N	Y	N	16-531	See below.


Description of Issue:

Current stock OK to ship to customers other than Bell Helicopter Mirabel.


If shipping to Bell Helicopter Mirabel: must ship D412-698-023 with enlarged D3594-043/-044/-3/-4. Eng. To sign off deviations on W/Os.
Change: addition of material, 0.25", on the inboard and outboard edges as shown to facilitate installation with existing equipment.

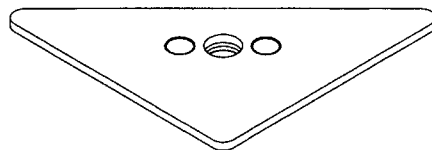


D3594-041 DOOR DOUBLER ASSEMBLY

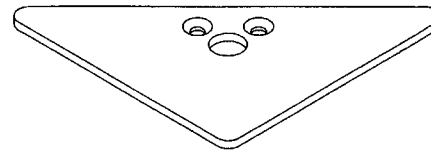

D3594-5 DOOR DOUBLER

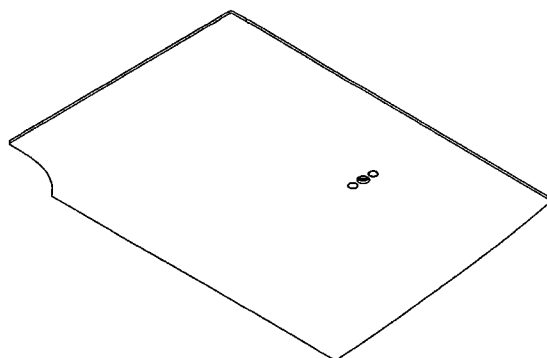

D3594-043 FLOOR DOUBLER ASSEMBLY


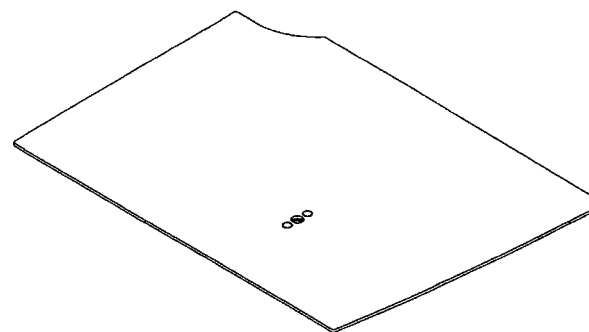


D3594-044 FLOOR DOUBLER ASSEMBLY


RELEASED
08.08.26

B	REFORMAT TO B SIZE DRAWING. SHEET 2 ADD -5.	AJS	08.05.14
A	NEW ISSUE	MB	07.04.13
REV.	DESCRIPTION	BY	DATE
DESIGN	MB	DART AEROSPACE LTD HAWKESBURY, ONTARIO, CANADA DRAWING NO. D3594 REV. B SHEET 1 OF 4 TITLE DOUBLER SCALE NTS COPYRIGHT © 2007 BY DART AEROSPACE LTD THIS DOCUMENT IS PRIVATE AND CONFIDENTIAL AND IS SUPPLIED ON THE EXPRESS CONDITION THAT IT IS NOT TO BE USED FOR ANY PURPOSE OR COPIED OR COMMUNICATED TO ANY OTHER PERSON WITHOUT WRITTEN PERMISSION FROM DART AEROSPACE LTD	
DRAWN	AJS		
CHECKED			
MFG. APPR.			
APPROVED			
DE APPR.			
DATE	08.05.14		


QTY. -041	PART NUMBER	DESCRIPTION
X	D3594-041	DOOR DOUBLER ASSEMBLY
1	D3594-1	DOOR DOUBLER
1	MS21069L5	ANCHOR NUT
2	MS20426AD4-4	RIVET, CSK

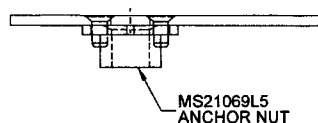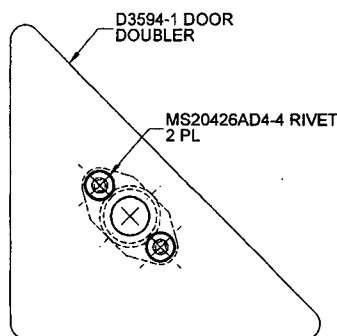


4 D3594-041 DOOR DOUBLER ASSEMBLY

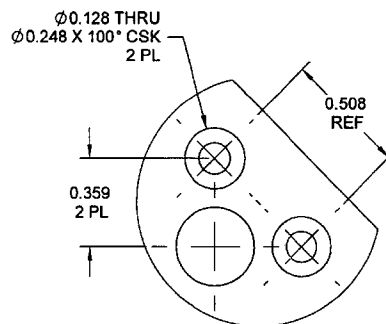

DETAIL A
SCALE 2X

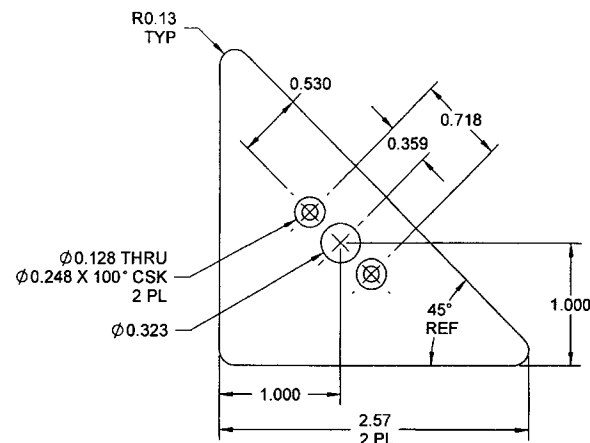

D3594-1 DOOR DOUBLER

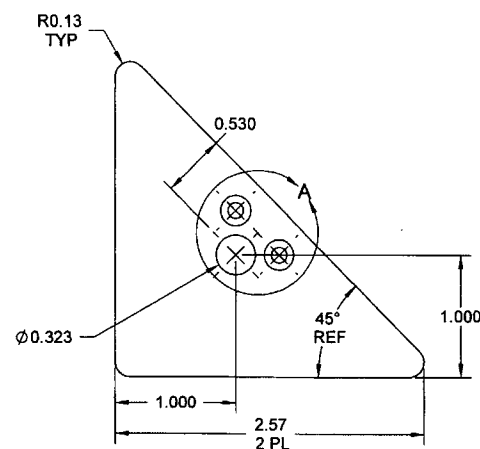

5 D3594-5 DOOR DOUBLER


NOTES:

- 1) MATERIAL: -1 & -5
6061-T6 (OR 6061-T62) ALUMINUM SHEET, 0.080 THICK,
PER AMS-QQ-A-250/11 OR AMS 4025 OR AMS 4027
(REF. DART SPEC. M8061T6S.080)
- 2) FINISH: CHEMICAL CONVERSION COAT PER DART QSI 005 4.1
- 3) TOLERANCES ARE PER DART QSI 018 UNLESS OTHERWISE NOTED
- 4) IDENTIFY WITH DART P/N "D3594-041" USING FINE POINT PERMANENT INK MARKER
- 5) IDENTIFY WITH DART P/N "D3594-5" USING FINE POINT PERMANENT INK MARKER
- 6) ALL DIMENSIONS ARE IN INCHES UNLESS OTHERWISE NOTED
- 7) BREAK ALL SHARP EDGES 0.005 TO 0.010 MAX
- 7) WEIGHT -041: 0.04 lbs
-5: 0.03 lbs


RELEASED
08-06-26-14

DESIGN	MB	DART AEROSPACE LTD HAWKESBURY, ONTARIO, CANADA	
DRAWN	AUS		
CHECKED		DRAWING NO.	REV. B
MFG. APPR.		D3594	SHEET 2 OF 4
APPROVED		TITLE	SCALE
DE APPR.		DOUBLER	NTS
DATE	08.05.14	COPYRIGHT © 2007 BY DART AEROSPACE LTD THIS DOCUMENT IS PRIVATE AND CONFIDENTIAL AND IS SUPPLIED ON THE EXPRESS CONDITION THAT IT IS NOT TO BE USED FOR ANY PURPOSE OR COPIED OR COMMUNICATED TO ANY OTHER PERSON WITHOUT WRITTEN PERMISSION FROM DART AEROSPACE LTD	

QTY. -043	QTY. -044	PART NUMBER	DESCRIPTION
X		D3594-043	FLOOR DOUBLER ASSEMBLY, LH
	X	D3594-044	FLOOR DOUBLER ASSEMBLY, RH
1		D3594-3	FLOOR DOUBLER, LH
	1	D3594-4	FLOOR DOUBLER, RH
1	1	MS21069L5	ANCHOR NUT
2	2	MS20426AD4-4	RIVET, CSK

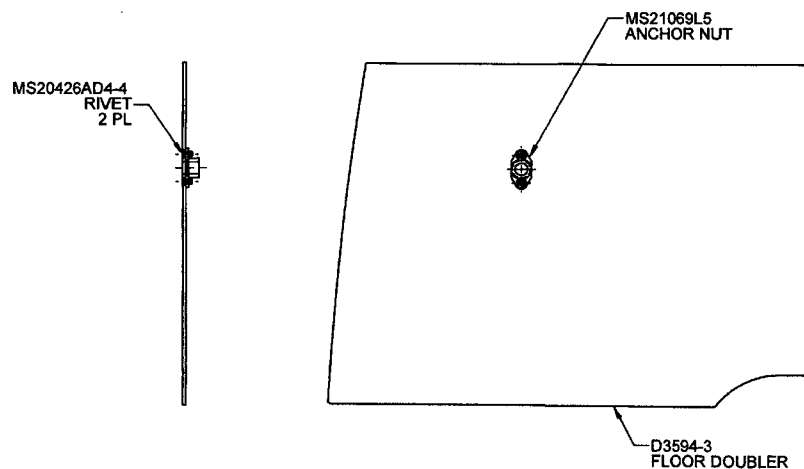

D3594-043 FLOOR DOUBLER ASSEMBLY

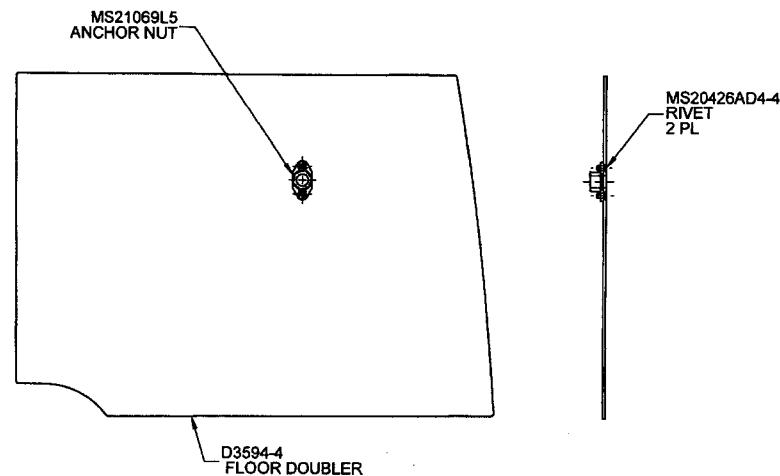


D3594-044 FLOOR DOUBLER ASSEMBLY

NOTES:

- 1) MATERIAL: -3 & -4
6061-T6 (OR 6061-T62) ALUMINUM SHEET, 0.080 THICK,
PER AMS-QQ-A-250/11 OR AMS 4025 OR AMS 4027
(REF. DART SPEC. M6061T6S.080)
- 2) FINISH: CHEMICAL CONVERSION COAT PER DART QSI 005 4.1
- 3) TOLERANCES ARE PER DART QSI 018 UNLESS OTHERWISE NOTED
- 4) IDENTIFY WITH DART P/N "D3594-043/-044" USING FINE POINT PERMANENT INK MARKER
- 5) ALL DIMENSIONS ARE IN INCHES UNLESS OTHERWISE NOTED
- 6) BREAK ALL SHARP EDGES 0.005 TO 0.010 MAX
- 7) WEIGHT -043 & -044: 0.80 lbs

DESIGN	MB	DART AEROSPACE LTD HAWKESBURY, ONTARIO, CANADA	
DRAWN	AJS		
CHECKED	J	DRAWING NO.	REV. B
MFG. APPR.	DS	D3594	SHEET 3 OF 4
APPROVED	12	TITLE	SCALE
DE APPR.	11	DOUBLER	NTS
DATE	08.05.14	COPYRIGHT © 2007 BY DART AEROSPACE LTD THIS DOCUMENT IS PRIVATE AND CONFIDENTIAL AND IS SUPPLIED ON THE EXPRESS CONDITION THAT IT IS NOT TO BE USED FOR ANY PURPOSE OR COPIED OR COMMUNICATED TO ANY OTHER PERSON WITHOUT WRITTEN PERMISSION FROM DART AEROSPACE LTD.	

RELEASED
08.06.14

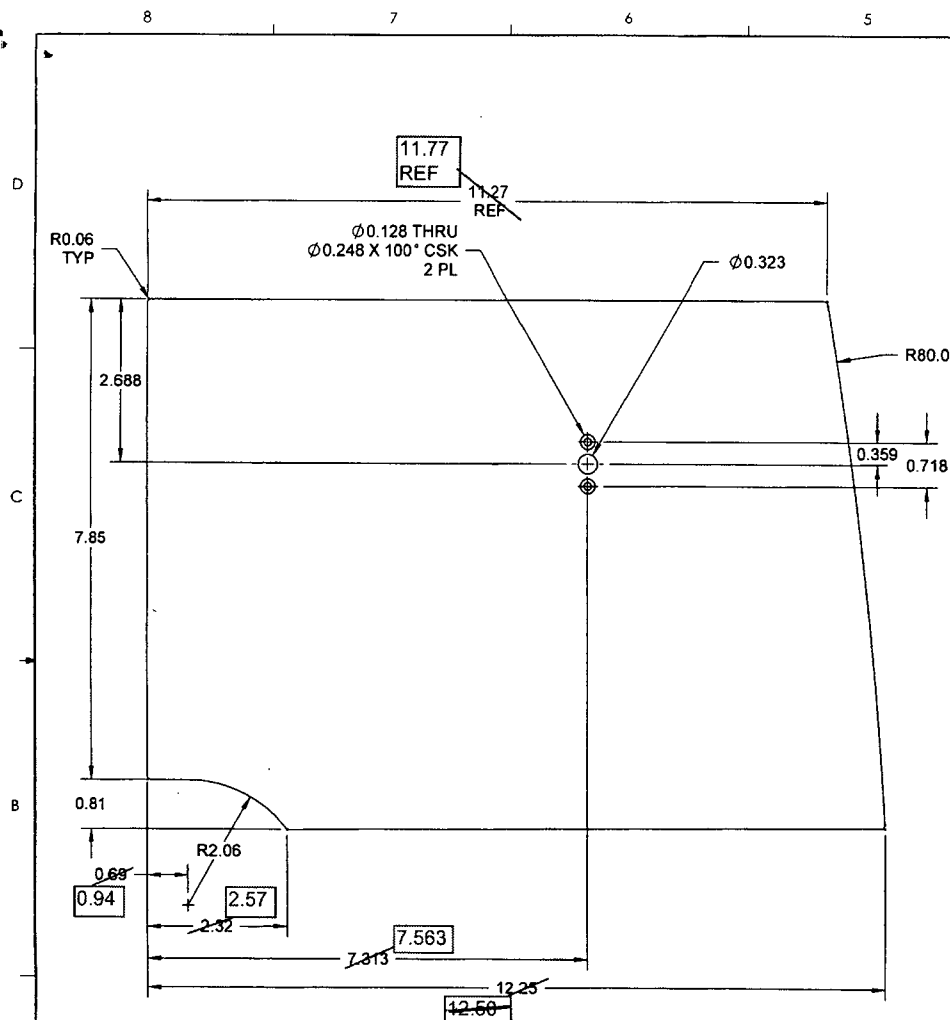


D3594-3 FLOOR DOUBLER

12.75

DAS
22
9-89

PAR 16-501

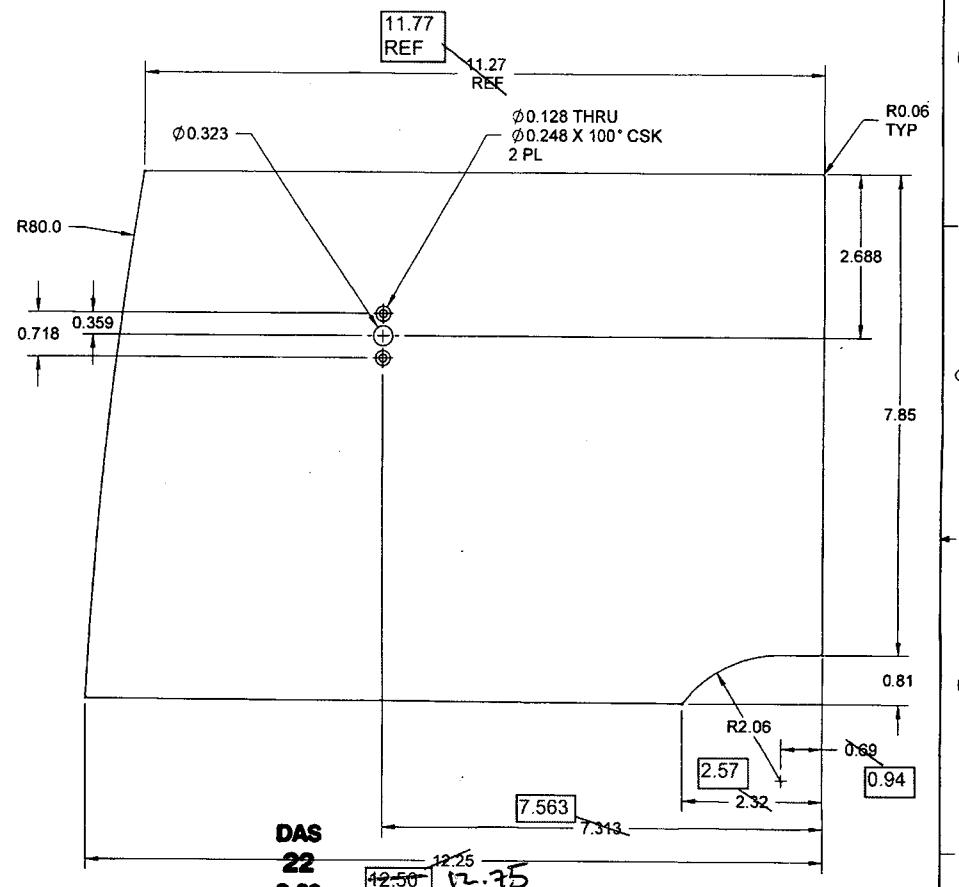

DAS
22
9-89

D3594-4 FLOOR DOUBLER

RELEASED
08082617

DESIGN	AJS	DART AEROSPACE LTD HAWKESBURY, ONTARIO, CANADA	
DRAWN	MB		
CHECKED		DRAWING NO. D3594	REV. B
MFG. APPR.		SHEET 4 OF 4	
APPROVED		TITLE	SCALE
DATE	08.05.14	COPYRIGHT © 2007 BY DART AEROSPACE LTD THIS DOCUMENT IS PRIVATE AND CONFIDENTIAL AND IS SUPPLIED ON THE EXPRESS CONDITION THAT IT IS NOT TO BE USED FOR ANY PURPOSE OR COPIED OR COMMUNICATED TO ANY OTHER PERSON WITHOUT WRITTEN PERMISSION FROM DART AEROSPACE LTD.	

DQA: _____ Date: _____



WORK ORDER NON-CONFORMANCE / UPDATE

QA Closed: _____ Date: _____

Work Order update only ☐

Work Order: _____ Part No. _____ NCR No. _____	DISPOSITION Rework ☐ Scrap ☐ Use-as-is ☐ Suspected Unapproved ☐	AGAINST DEPARTMENT/PROCESS Skid-tube ☐ Machining ☐ Thermoforming ☐ Large Fab ☐ Cross tube ☐ Small Fab ☐ Finishing ☐ Composite ☐ Water Jet ☐ Prod. Eng. Coord. ☐ Rec/Store/Packaging ☐ Supplier ☐ Engineering ☐ Quality ☐ Other ☐					
Date : _____		Step #: _____		QTY Effective : _____		MRB (QSI042) Approval 	
Description Work Order Deviation				Disposition			
						Completed By	
						Lead hand / Supervisor Approval Verification	
				QC / QA Coordinator Approval			
Root Cause		FAULT CATEGORY					
Environment ☐ Design ☐ Doc/Data ☐ Equip/Tooling ☐ Handling/Pre ☐ Material ☐ Internal Transport ☐ Tribal Knowledge ☐ LOA ☐ Substation ☐ Past Expiry Date ☐ Misidentified ☐	No Re-verification ☐ Operator ☐ Offset/Setup ☐ Supplier ☐ Training ☐ Use for Testing ☐ Poor Information ☐ Rushing ☐ Product Improvement ☐ Process Improvement ☐ Manufacturing Process ☐ Past Due ☐	Pressure/Forced ☐ Bending ☐ Centre Not Concentric ☐ Cracks ☐ Crimp/Kink/Ripple/Wave ☐ Cuffs ☐ Crushing ☐ Heat Treat ☐ Wave/Twist in Tube ☐ Marks/Chatter ☐	Temperature/Cure ☐ Set-up ☐ BOM/Route ☐ Broken/Damage/Defect ☐ Inspection Incomplete/Unqualified ☐ Contamination ☐ Countersink ☐ Cut Too Short ☐ Instructions Incomplete/Unclear ☐ Drill Holes ☐	Power Loss/Surge ☐ Folio/Program ☐ Grain ☐ Weld ☐ Wrong Stock Pulled ☐ Out of Sequence ☐ Off-set ☐ Misabeled ☐ Fit/Function ☐ Misaligned/off center ☐	Positioned Wrong ☐ Outside Dimensions ☐ Over/Under tolerance ☐ Part Incorrect ☐ Part Lost/Missing ☐ Part Moved ☐ Drawing ☐ Finish ☐ Misread ☐ Turning Sequence ☐		
OTHER : _____							

